



Unit 9-6, U-Stor Business Units, Spylaw Road, Kelso, TD5 8DN

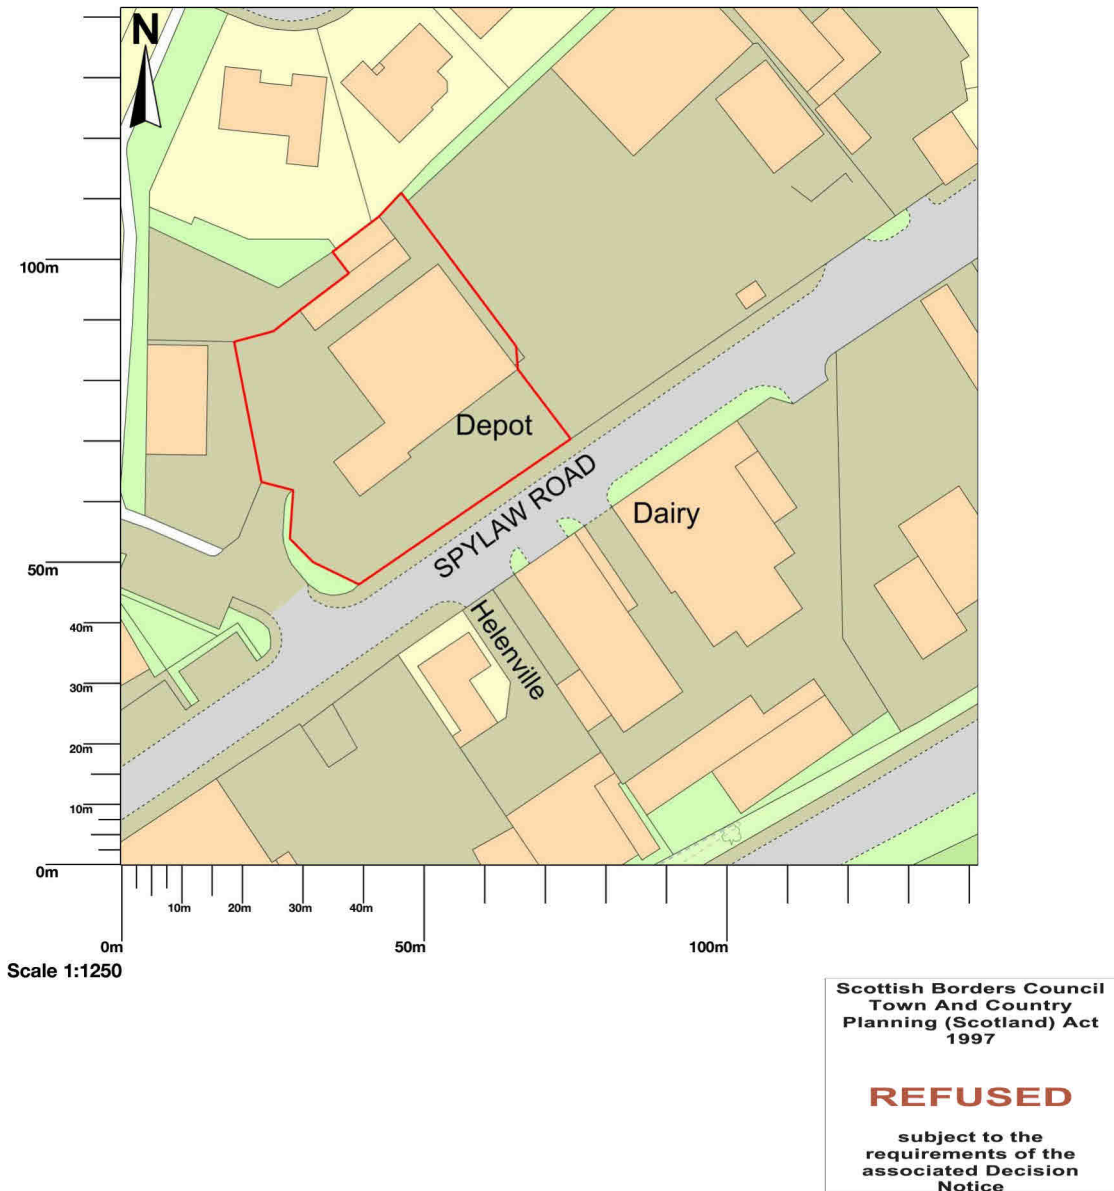

23/00325/FUL
26/04/2023

Health & Safety Information

There are no issues associated with this drawing - information is generally "as-built"

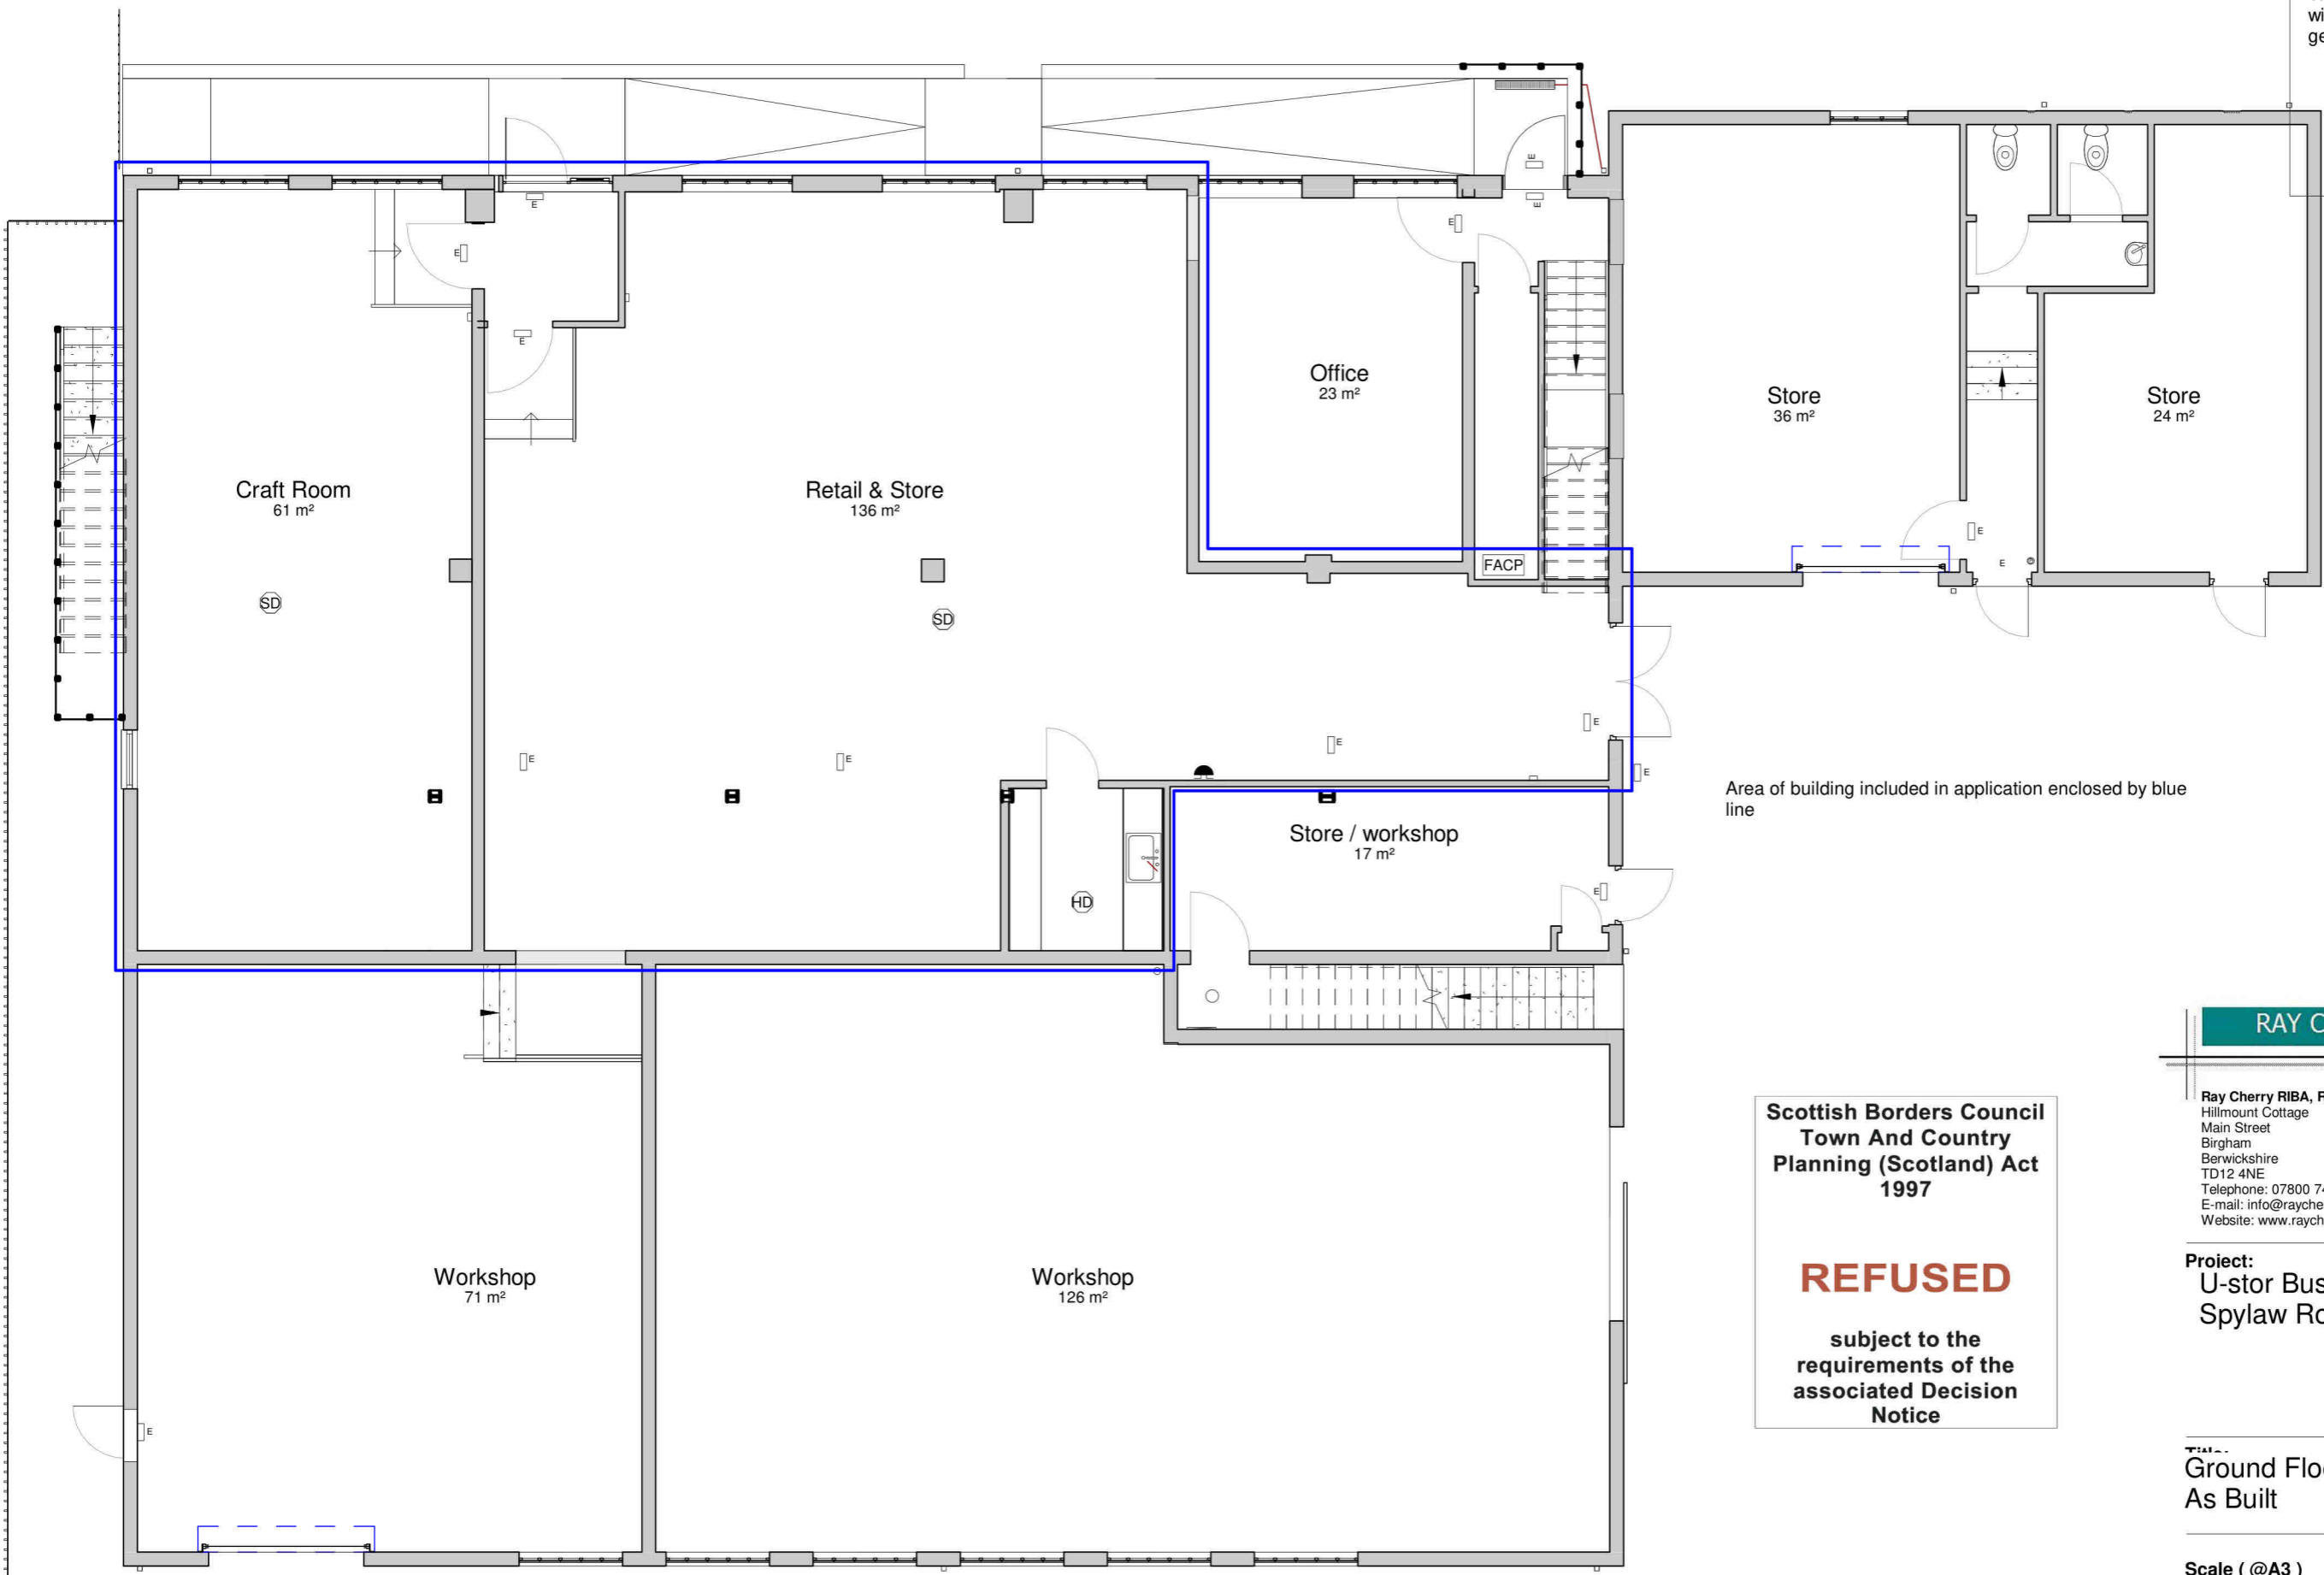

Area of building included in application enclosed by blue line

**Scottish Borders Council
Town And Country
Planning (Scotland) Act
1997**

REFUSED

**subject to the
requirements of the
associated Decision
Notice**

RAY CHERRY ARCHITECT

Ray Cherry RIBA, RIAS, IMAPS
Hillmount Cottage
Main Street
Birgham
Berwickshire
TD12 4NE
Telephone: 07800 749 806
E-mail: info@raycherry-architect.co.uk
Website: www.raycherry-architect.co.uk

Project:
U-stor Business Units Ltd
Spylaw Road, Kelso

**Ground Floor Plan -
As Built**

Scale (@A3) 1 : 100

Date: February 2023 **Project No.:** 22-016

Drg. No.: 201 **Rev.:** P1


23/00325/FUL
26/04/2023

Health & Safety Information

There are no issues associated with this drawing - information is generally "as-built"



Car parking spaces shown.
NB some of this area was used previously for container storage which has since been removed.

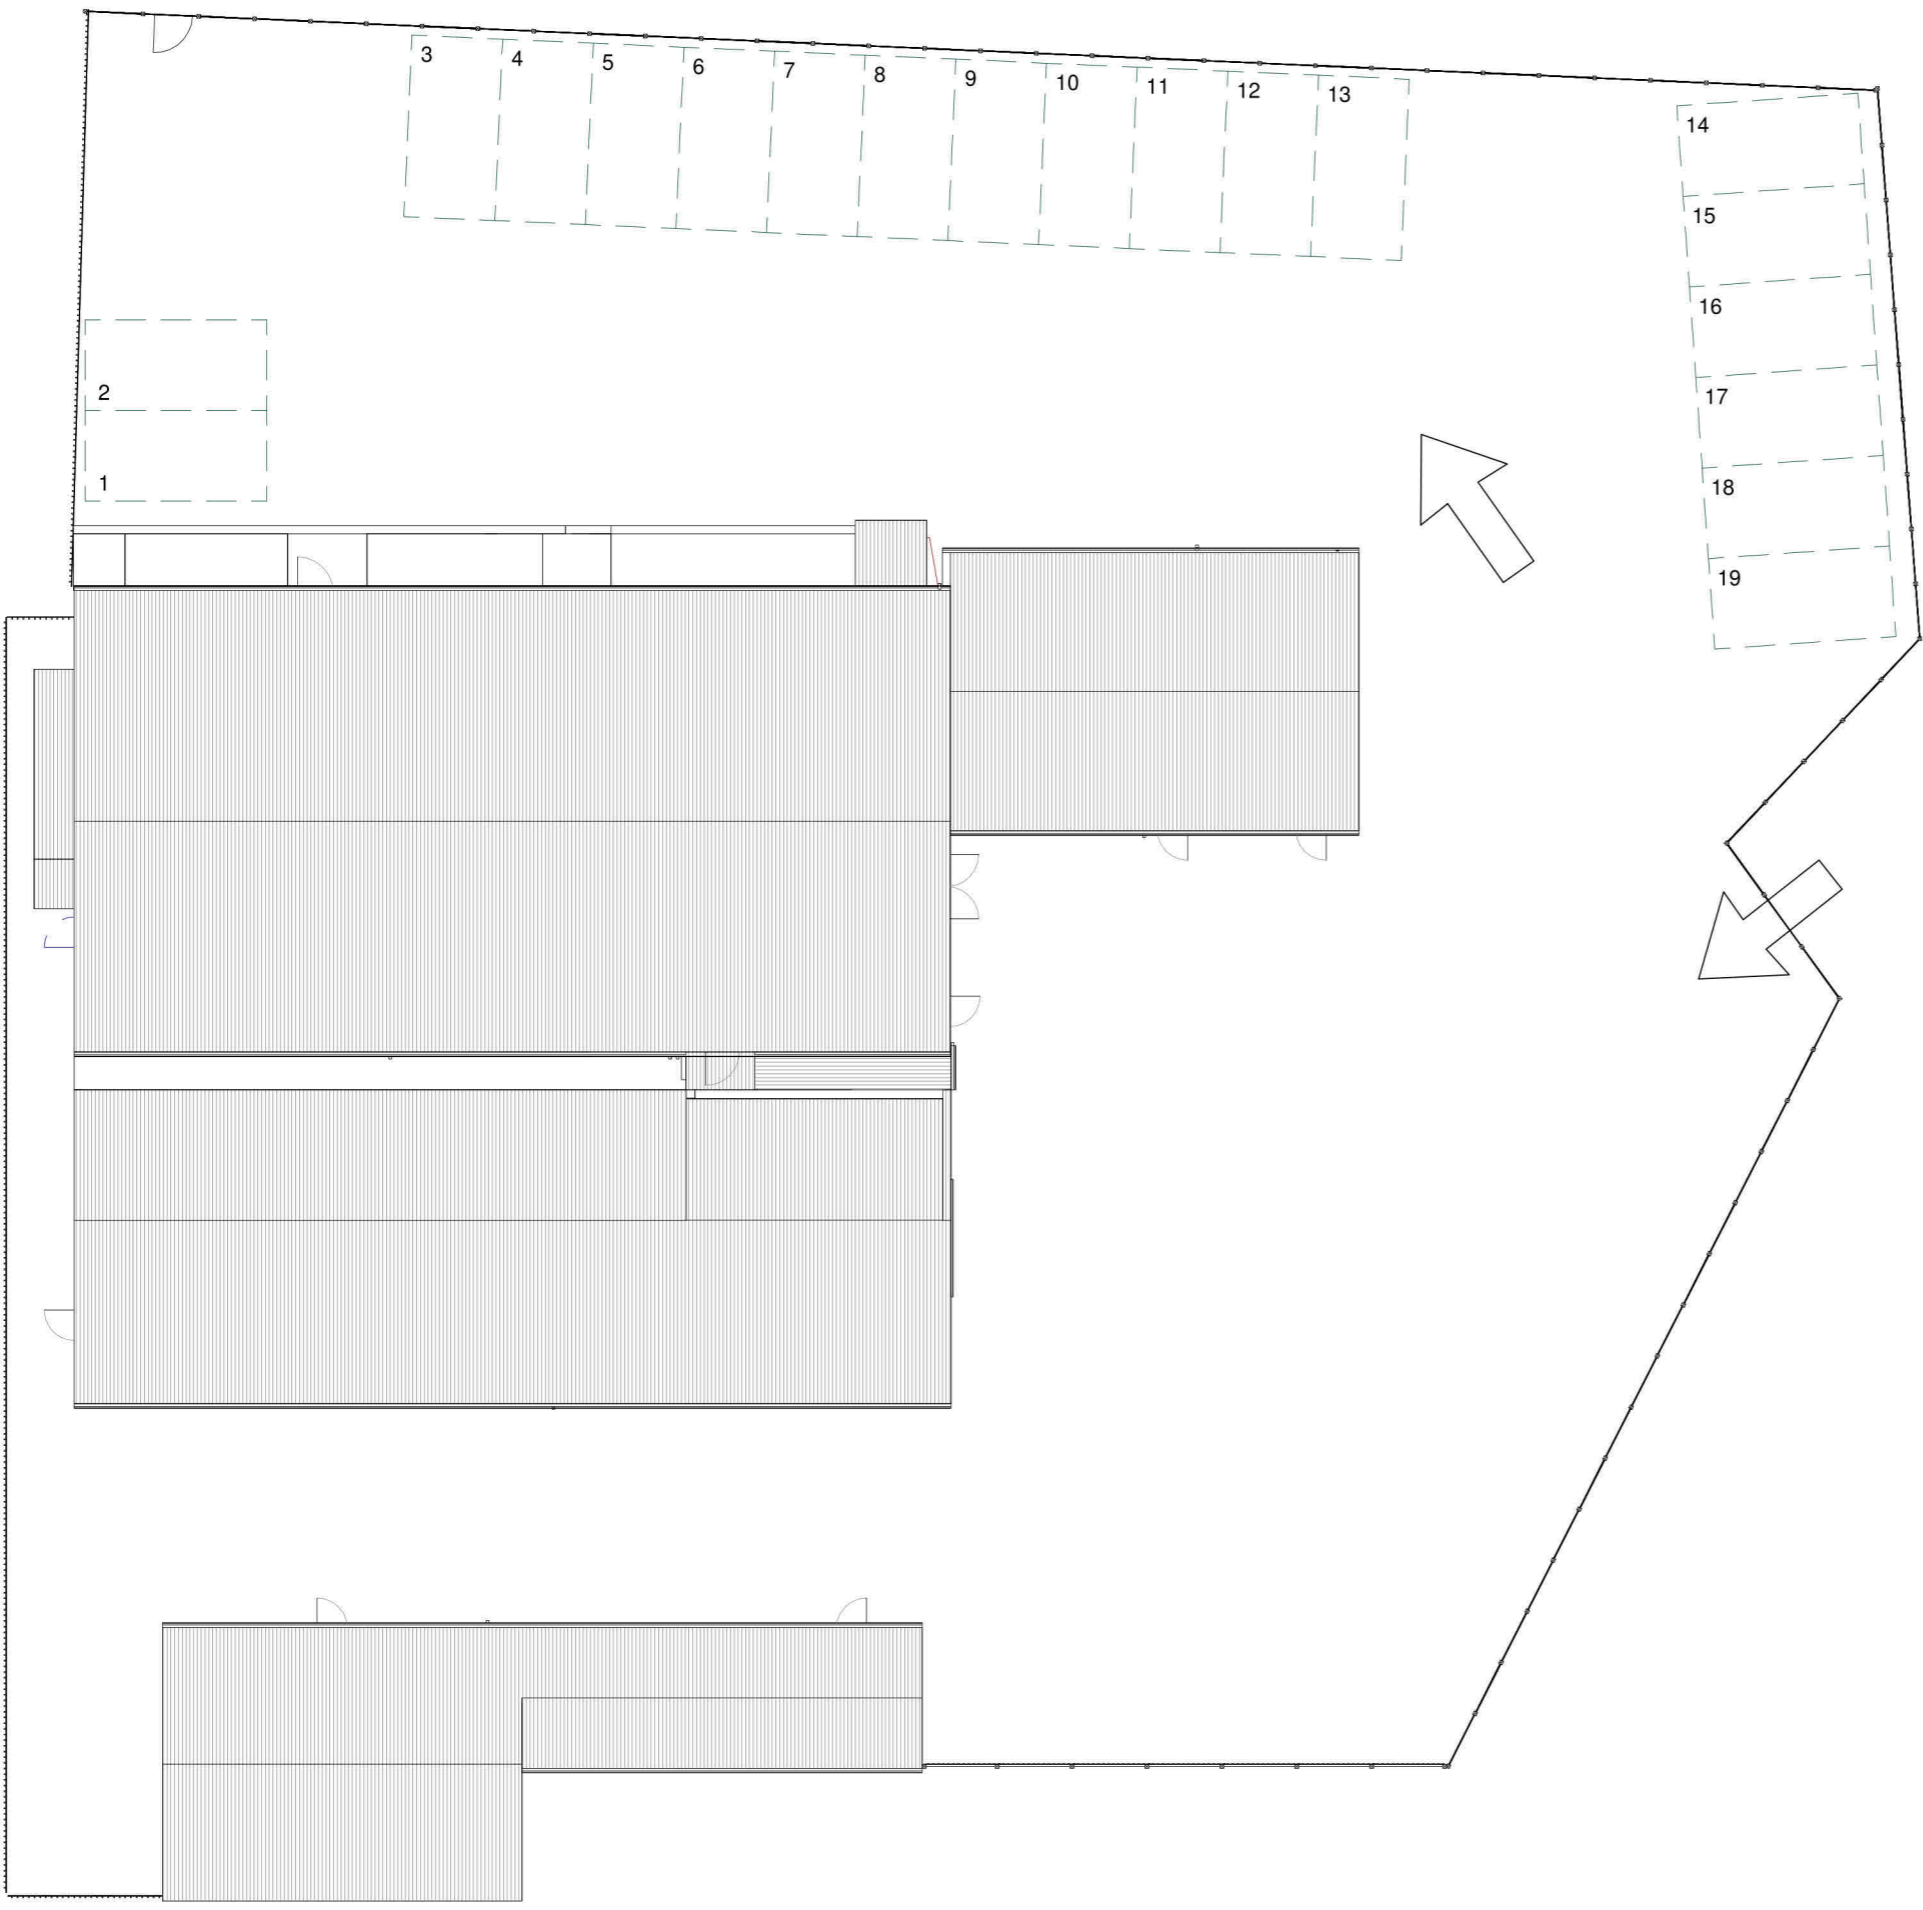

RAY CHERRY ARCHITECT

Ray Cherry RIBA, RIAS, IMAPS
Hillmount Cottage
Main Street
Birgham
Berwickshire
TD12 4NE
Telephone: 07800 749 806
E-mail: info@raycherry-architect.co.uk
Website: www.raycherry-architect.co.uk

Project:
U-stor Business Units Ltd
Splylaw Road, Kelso

**Scottish Borders Council
Town And Country
Planning (Scotland) Act
1997**

REFUSED

subject to the
requirements of the
associated Decision
Notice

**Site Plan Showing
Parking**

Scale (@A3) 1 : 200

Date: March 2023 Project No.: 22-016

Drg. No.: 301 Rev.: P1